

FIRST FLOOR AREA 763 SQFT
(INCLUDING GARAGE)
TOTAL FLOOR AREA 1573 SQFT
UNIT 7

FIRST FLOOR AREA 763 SQFT
(INCLUDING GARAGE)
TOTAL FLOOR AREA 1573 SQFT
UNIT 5

FIRST FLOOR AREA 763 SQFT
(INCLUDING GARAGE)
TOTAL FLOOR AREA 1573 SQFT
UNIT 3

FIRST FLOOR AREA 763 SQFT
(INCLUDING GARAGE)
TOTAL FLOOR AREA 1573 SQFT
UNIT 1


PHASE I BUILDING I FIRST FLOOR

CEILING HEIGHT 8'-0" TYPICAL ALL UNITS

I HEREBY CERTIFY THAT THESE PLANS DEPICT THE AS-BUILT DIMENSIONS OF THE UNITS, THAT THEY ARE SUBSTANTIALLY COMPLETE AND THE FLOOR PLAN COMPLETES WITH THE PROVISIONS OF R.S.A. CHAPTER 356-B:20,11.

John L. Chase, PE
JOHN L. CHASE, PE

COPYRIGHT © 1988
SCHOFIELD BROTHERS, INC.

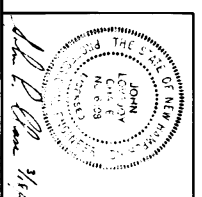


REV. NO.	DATE	DESCRIPTION	BY

FLOOR PLAN
TIDEVIEW ESTATES, A CONDOMINIUM
FOR JADE REALTY CORPORATION
AMHERST, N.H.

DURGIN-SCHOFFIELD ASSOCIATES
ENGINEERING, ARCHITECTURE, PLANNING
A Division of Standard Building Inc.
448 U.S. ROUTE 1 BY PASADENA
PORTSMOUTH, N.H. 02871
TELEPHONE 838-2887

PROJ. MGR. _____
APPROVED BY: *[Signature]*
DRAWN BY: *[Signature]*

CHECKED BY: *[Signature]*
DATE: _____
SCALE: 1/4" = 1'-0"
JOB NO. P-01023
PLAN NO. A-600
SHEET 02

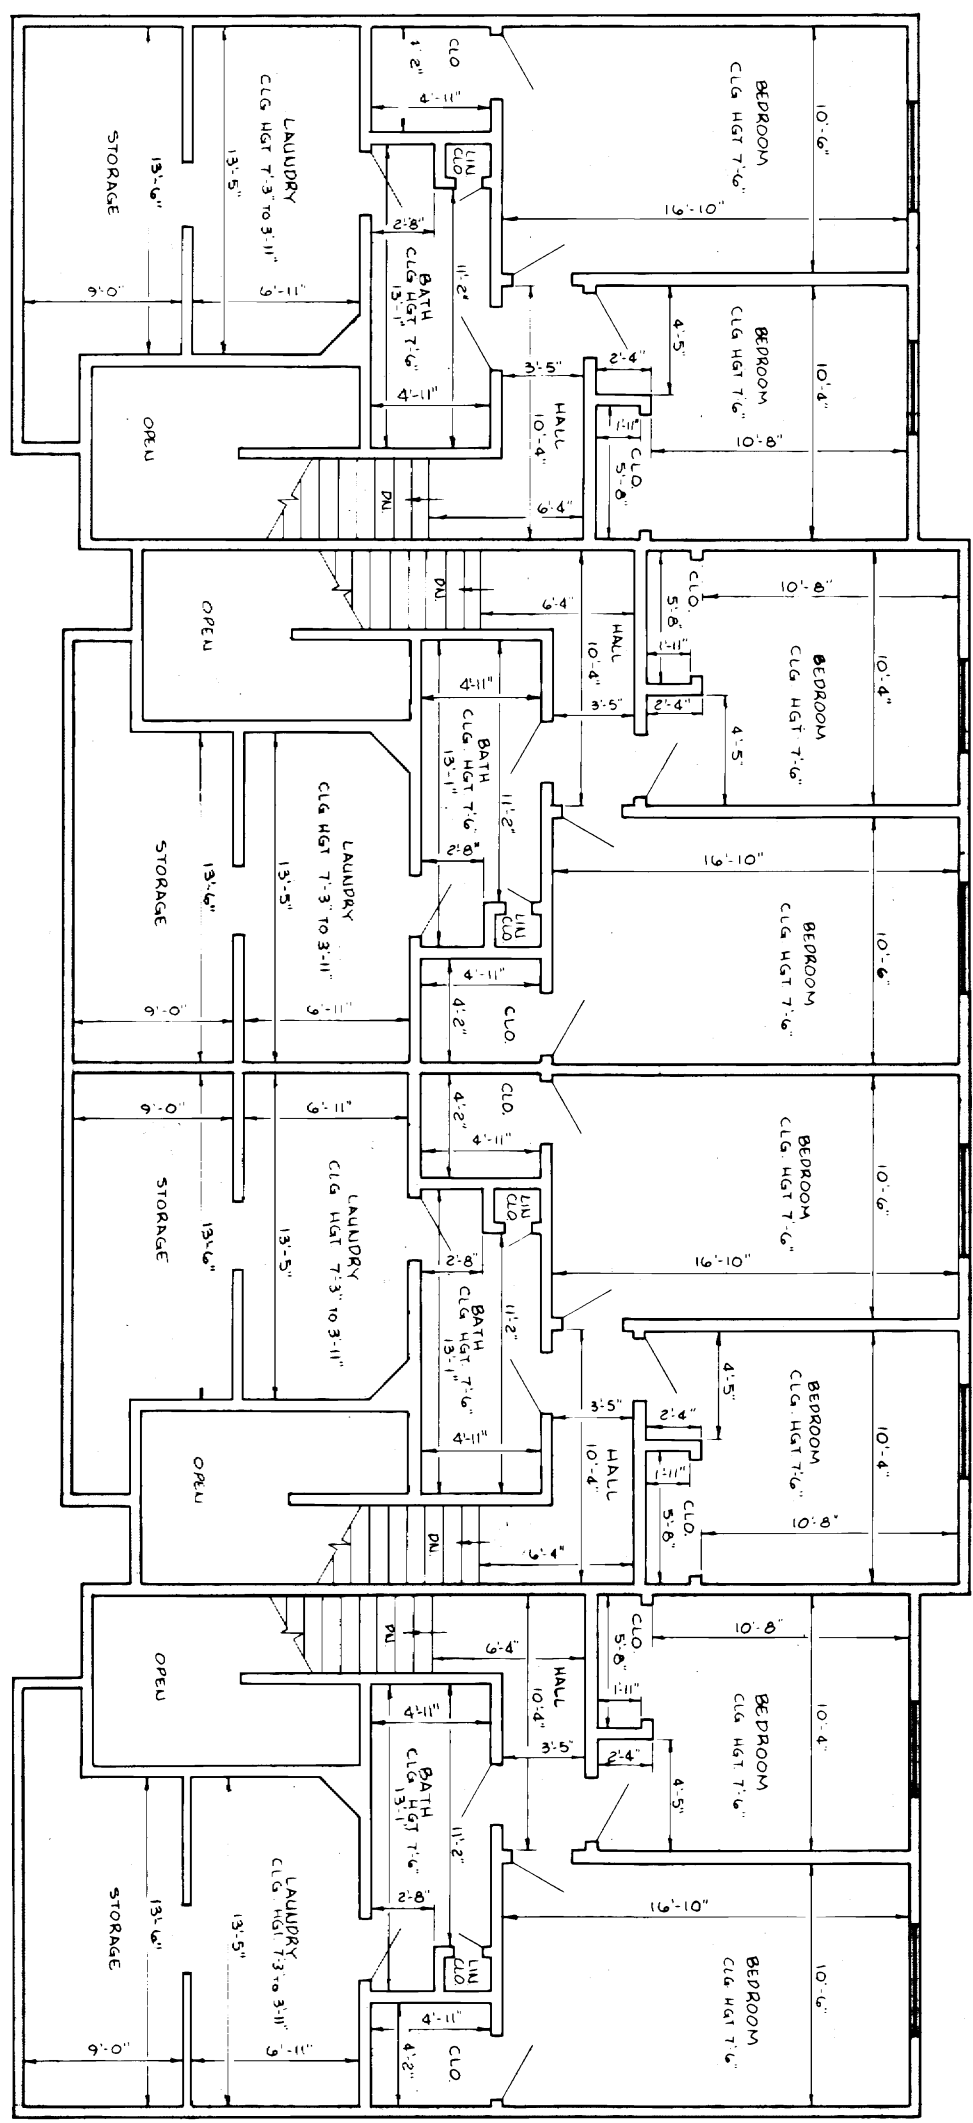

SECOND FLOOR AREA 810 SQ. FT.

UNIT 7

SECOND FLOOR AREA 810 SQ. FT.

UNIT 5

SECOND FLOOR AREA 810 SQ. FT.

UNIT 3

SECOND FLOOR AREA 810 SQ. FT.


UNIT 1

PHASE I
BUILDING I
SECOND FLOOR

I HEREBY CERTIFY THAT THESE PLANS DEPICT THE AS-BUILT DIMENSIONS OF THE UNITS, THAT THEY ARE SUBSTANTIALLY COMPLETE AND THE FLOOR PLAN COMPLIES WITH THE PROVISIONS OF R.S.A. CHAPTER 356-B:20, 11.

JOHN L. CHASE, P.E.

COPYRIGHT © 1988
SCHORFELD BROTHERS, INC.

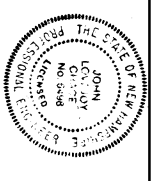

FLOOR PLAN
TIDEVIEW ESTATES, A CONDOMINIUM
FOR JADE REALTY CORPORATION
AMHERST, N.H.

DURGIN-SCHOEFEL ASSOCIATES
ENGINEERING, ARCHITECTURE, PLANNING
A Division of Schorfeld Brothers, Inc.
400 U.S. ROUTE 1, DOVER, N.H. 03820
TELEPHONE: 236-1111

DATE: _____
SCALE: 1/4" = 1'-0"
JOB NO.: P-01023
PLAN NO.: A-600
SHEET: _____ OF _____

PROJ. NO.: _____
APPROVED BY: _____
CHECKED BY: _____
DRAWN BY: _____

REV. NO.	DATE	DESCRIPTION	BY